
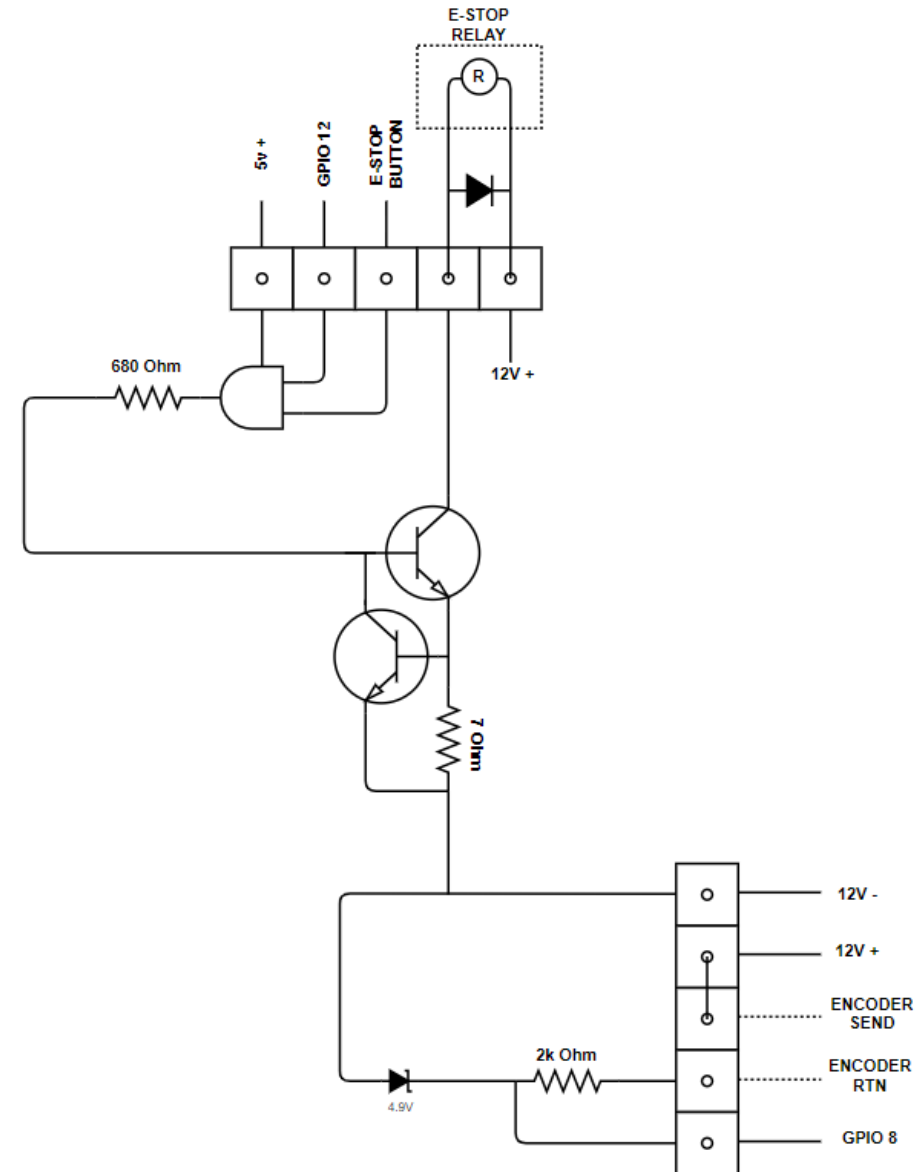


Associated Drawings:
RTR-W002_r1

| | | | | | |
|-----|-----------------------------|------------|--------|------------------|--|
| Rev | Details | Date | Author | Drawing Number: | RTR-W001_r0 |
| 0 | Values and BOM still needed | 12/03/2019 | JS | Description: | Control Box - Controller wiring diagram and pin assignment |
| 1 | As Built | 03/01/2020 | JS | Date | 03/01/2020 |
| | | | | Revision Number: | 1 |
| | | | | Client: | Doepker Industries |

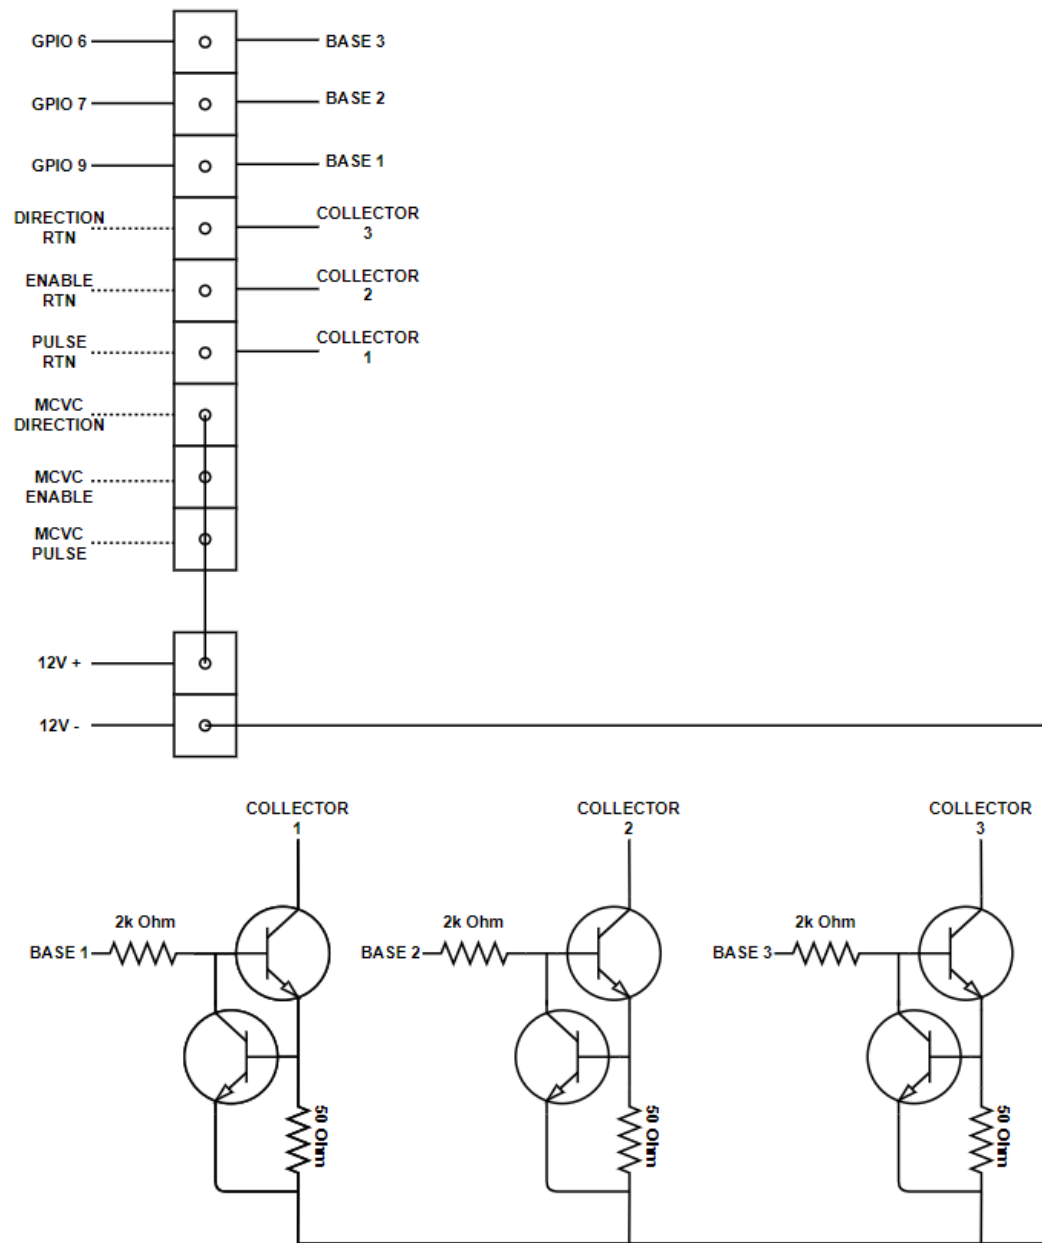

Associated Drawings:
RTR-W001_r1

| Rev | Details | Date | Author | Drawing Number: | RTR-W002_r0 |
|-----|-----------------------------|------------|--------|------------------|--|
| 0 | Values and BOM still needed | 12/03/2019 | JS | Description: | Control Box - Controller wiring diagram and pin assignment-2 |
| 1 | As Built | 03/01/2020 | JS | Date: | 03/01/2020 |
| | | | | Revision Number: | 1 |
| | | | | Client: | Doepker Industries |